

+8095 Ridge
▽

+4870 Window Head / Soffit
▽


+3785 Window Cill
▽

+2730 First Floor Level
▽

+2235 Ceiling
▽

+1870 Door Head
▽

+000 Finished Floor Level (Main House)
▽

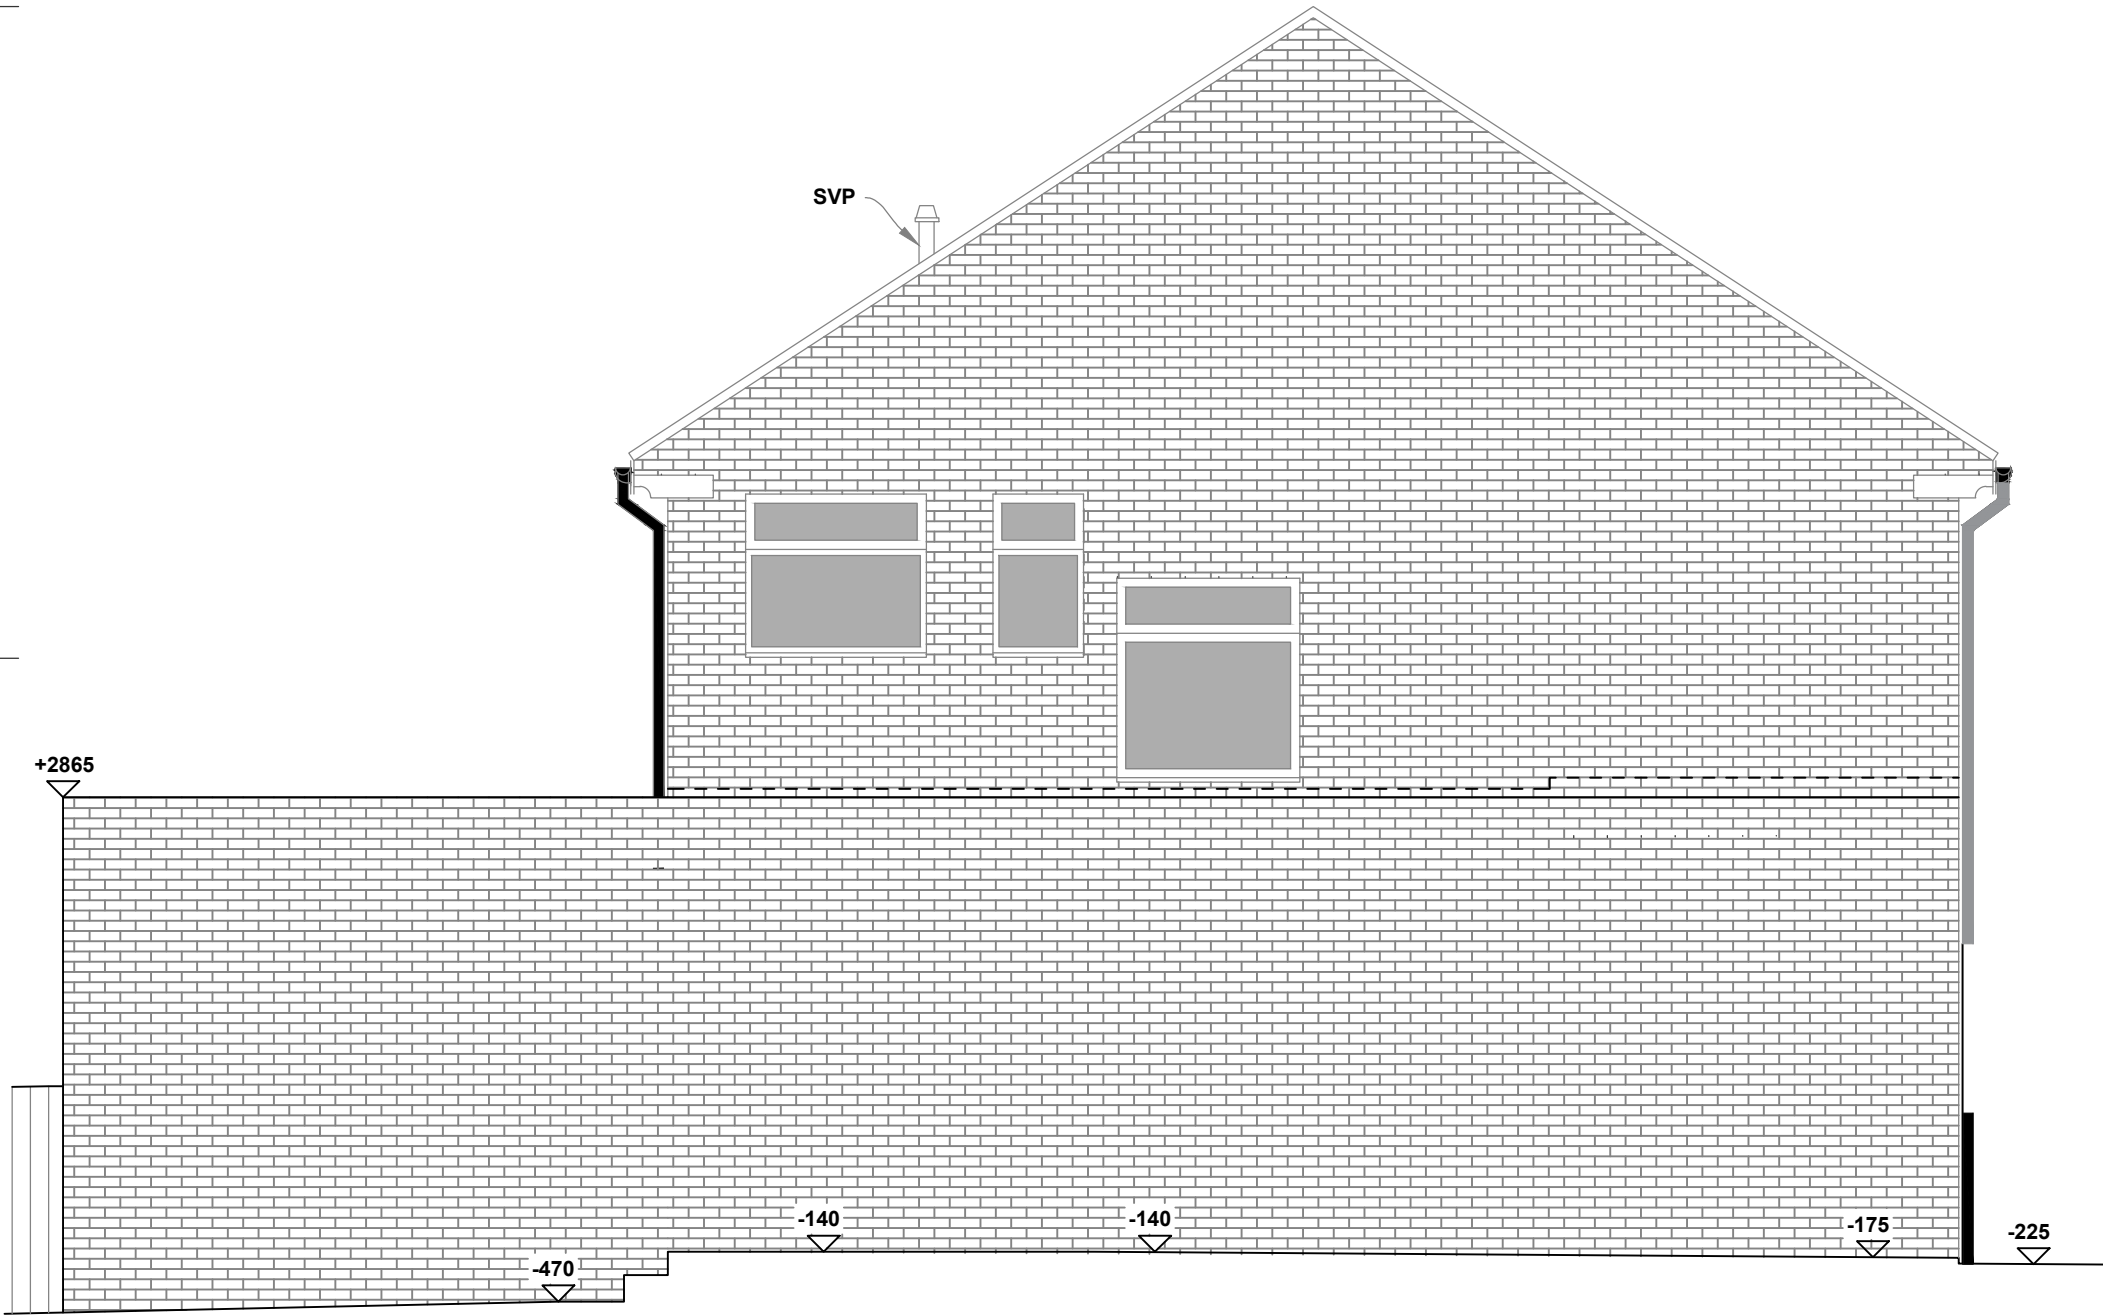

AS-BUILTS

CLIENT:
EMILY BELL

PROJECT:
10 LABURNUM GROVE,
SUNNISIDE

TITLE:
GABLE ELEVATION

SCALE:
1:50@ A3

DATE:
11/06/2026

DRAWN BY:
N/A

CHECKED BY:
N/A

DRAWING NO:
0002

REV:
01

