


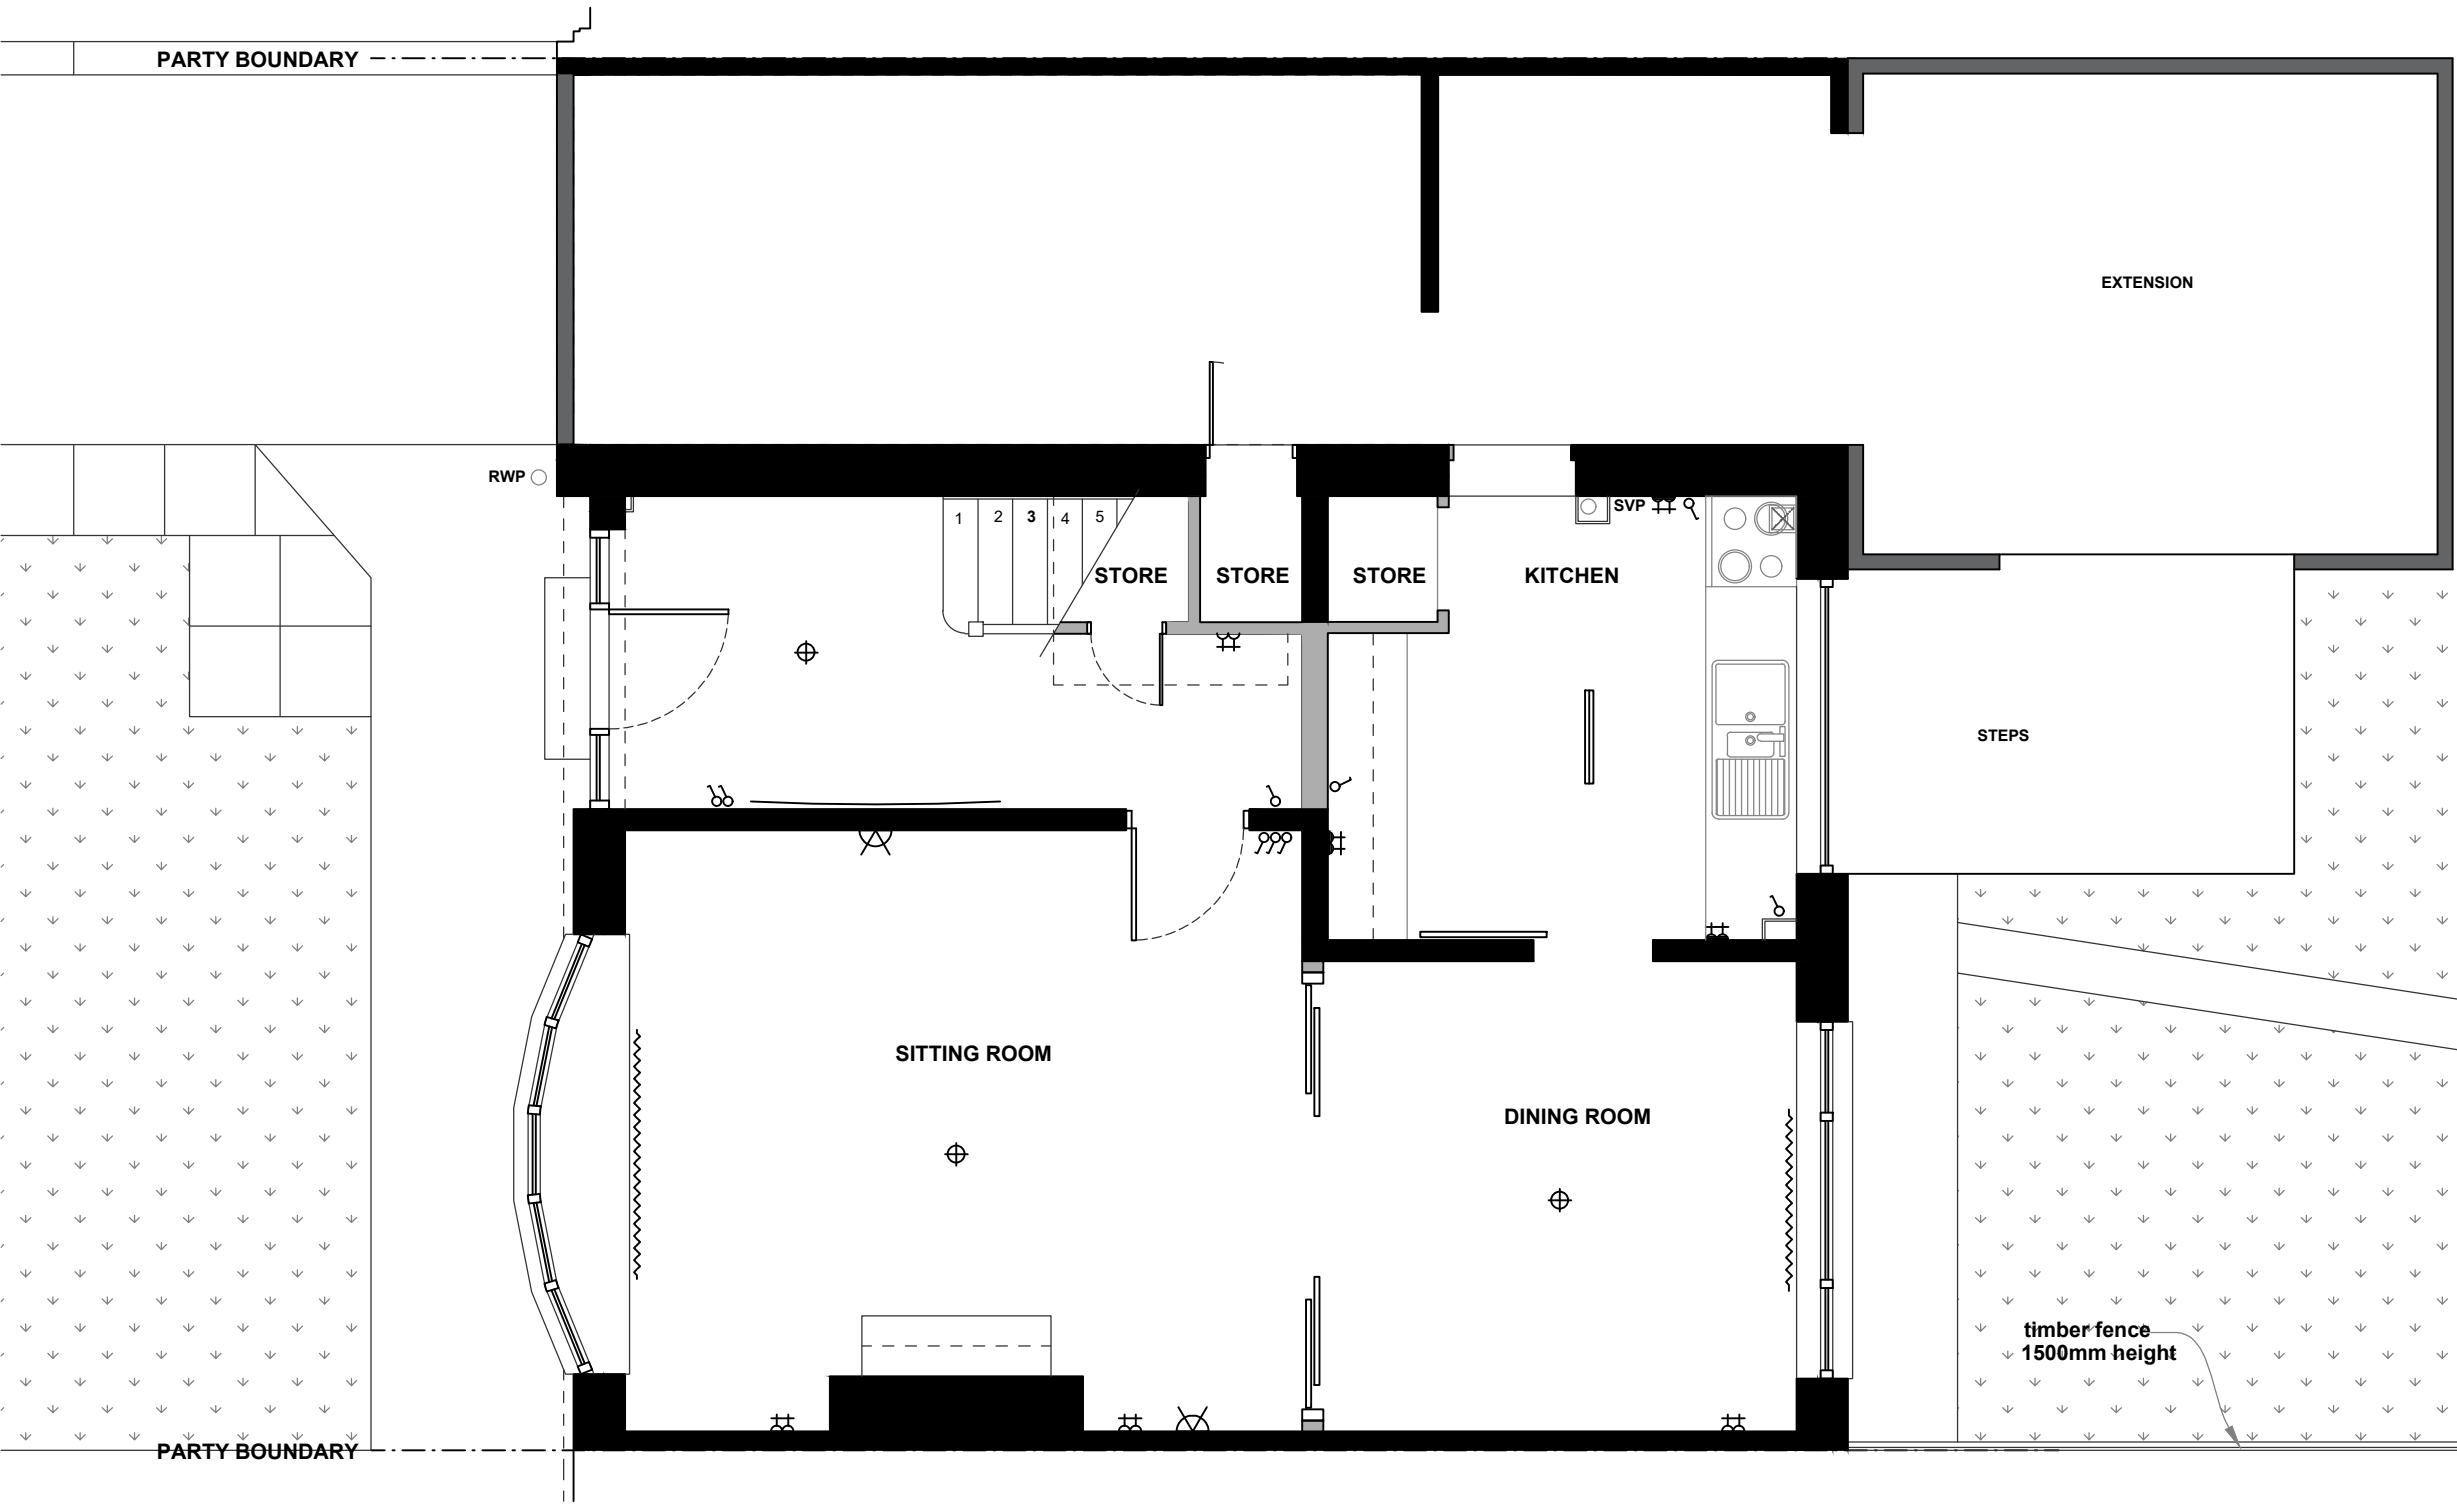

AS-BUILTS

CLIENT:		EMILY BELL	
PROJECT:		10 LABURNUM GROVE, SUNNYSIDE	
TITLE:		GROUND FLOOR PLAN	
SCALE:	1:50@ A3	DATE:	11/06/2026
DRAWN BY:	N/A	CHECKED BY:	N/A
DRAWING NO:	0003	REV:	01