


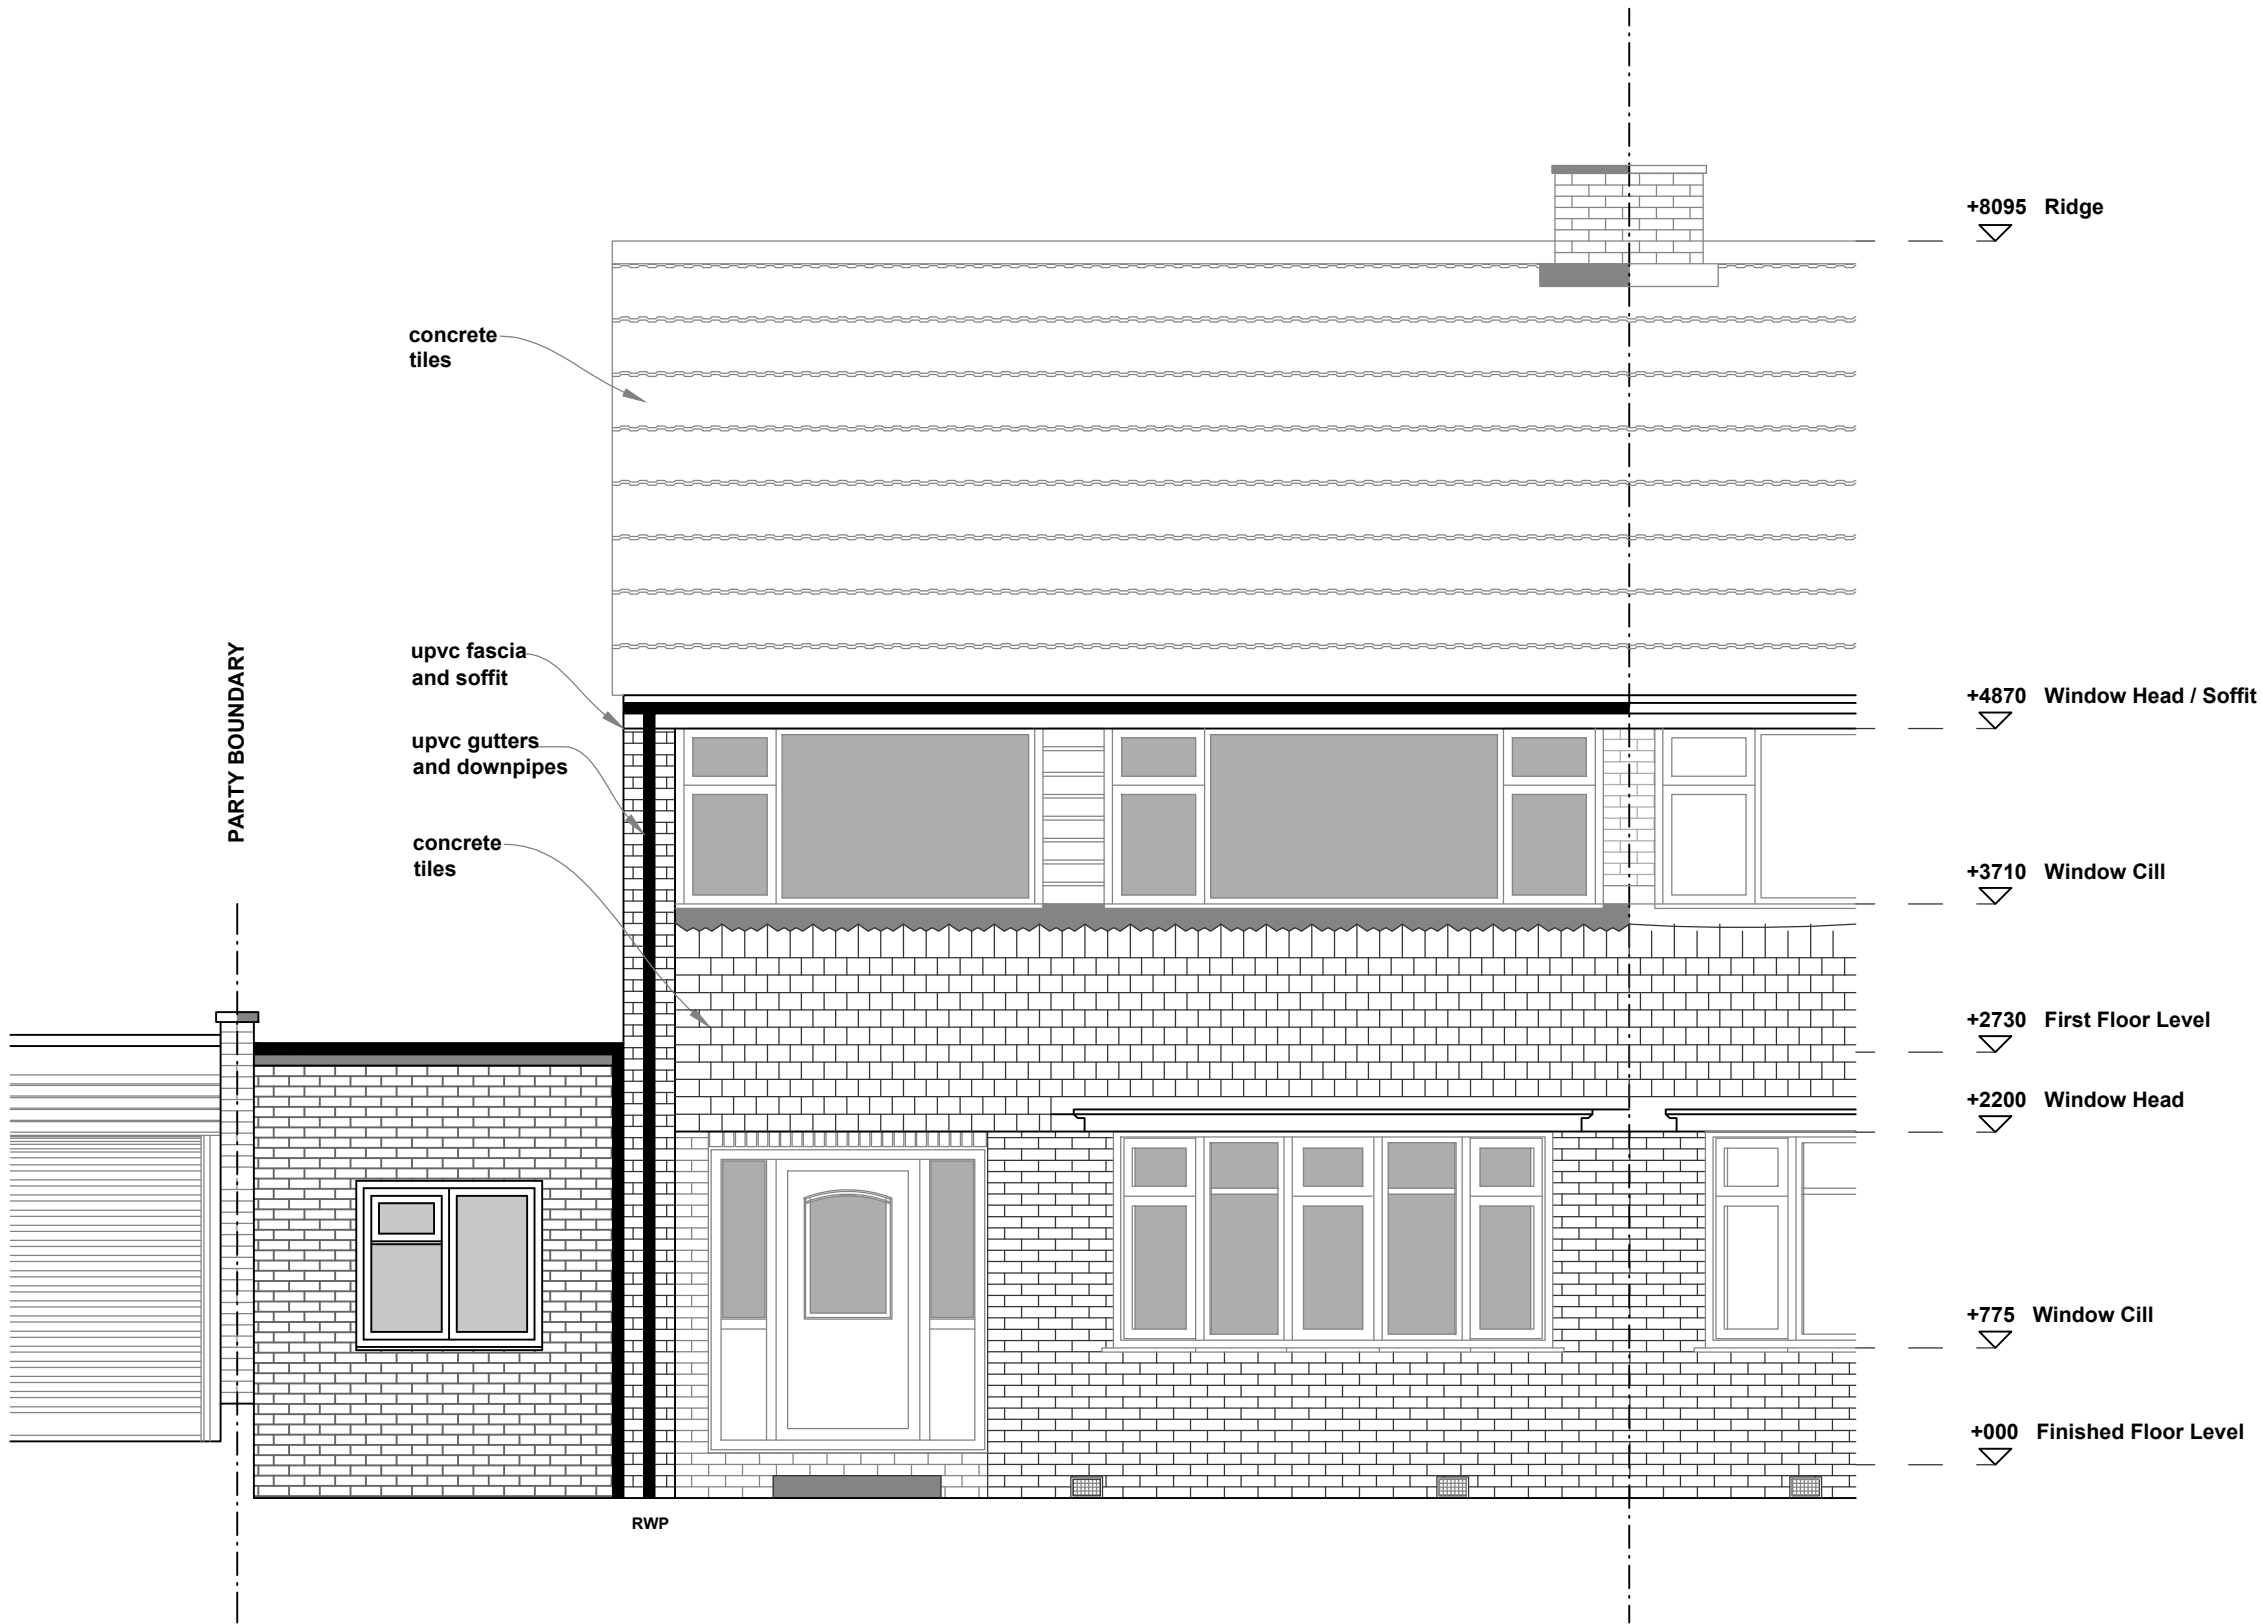

AS-BUILTS

CLIENT:	
EMILY BELL	
PROJECT:	
10 LABURNUM GROVE, SUNNYSIDE	
TITLE:	
FRONT ELEVATION (SOUTH WEST)	
SCALE:	DATE:
1:50@ A3	11/06/2026
DRAWN BY:	CHECKED BY:
N/A	N/A
DRAWING NO:	REV:
0004	01

THIS DRAWING AND DESIGN IS THE SOLE PROPERTY OF EMILY BELL AND MUST NOT BE COPIED,
LOANED OR COMMUNICATED, IN WHOLE OR PART TO ANY THIRD PARTY WITHOUT CONSENT FROM EMILY BELL.